

Date: Monday, 17/07/2006 11:15:47 AM
User: Linda Lacelle

Process Sheet

Customer : CU-DAR001 Dart Helicopters Services	Drawing Name : BUSHING
Job Number : 27931	
Estimate Number : 10310	
P.O. Number : N/A	Part Number : D26175
This Issue : 17/07/2006 S.O. No. : N/A	Drawing Number : D2617 REV D2
Prsht Rev. : NC	Project Number : N/A
First Issue : N/A Type : MACHINED PARTS	Drawing Revision : D2
Previous Run : 27544	Material : N/A
Written By : <u>SEE COMMENT BELOW</u>	Due Date : 24/07/2006
Checked & Approved By : <u>[Signature]</u>	Qty: <u>14</u> Um: Each
Comment : Est H 04.07.14 Reformat; added step 5 KJ/JLM	

Additional Product

Job Number:



Seq. #:	Machine Or Operation:	Description :
----------------	------------------------------	----------------------

1.0	M6061T6T0500W058	6061-T6 Tube .500 x.058W
-----	------------------	--------------------------



Comment: Qty.: 0.0205 f(s)/Unit Total : 0.2048 f(s)
6061-T6 Round Bar 1.5"
Material: 6061-T6 (QQ-A-225/8 or QQ-A-200/8 or WW-T-700/6)
Ø0.500" tubing x 0.058" wall
M6061T6T0.500W.058)
Batch M100309

[Signature] 06/07/19

2.0	HARDINGE	HARDINGE CNC LATHE SMALL
-----	----------	--------------------------



Comment: HARDINGE CNC LATHE SMALL

1-Machine as per Folio FA438 and Dwg D2617
2-Deburr

N/A Machined Manually

[Signature] 06/07/19 14

3.0	QC2	INSPECT PARTS AS THEY COME OFF MACHINE
-----	-----	--



Comment: INSPECT PARTS AS THEY COME OFF MACHINE

[Signature] 06/07/19 14

4.0	QC8	SECOND CHECK
-----	-----	--------------



Comment: SECOND CHECK

SA 06.07.19 14

Date: Monday, 17/07/2006 11:15:47 AM
User: Linda Lacelle

Process Sheet

Customer: CU-DAR001 Dart Helicopters Services

Drawing Name: BUSHING

Job Number: 27931

Part Number: D26175

Job Number:



Seq. #:

Machine Or Operation:

Description :

5.0

HAND FINISHING1

HAND FINISHING RESOURCE #1



Comment: HAND FINISHING RESOURCE #1

Acid etch and Alodine as per QSI 005 4.1

SAH 06/07/21

(10)

6.0

QC3

INSPECT POWDER COAT/CHEMICAL CONVERSION



Comment: INSPECT ALODINE

SB 06/07/21 10

7.0

PACKAGING 1

PACKAGING RESOURCE #1



Comment: PACKAGING RESOURCE #1

Identify and Stock

Location: ST33

* does not scan

AL 06/07/21 (10)

8.0

DC

DOCUMENT CONTROL



Comment: DOCUMENT CONTROL

Inspection Level 21

SP 06/08/01 (10)

Job Completion




C206107131




DESIGN	BW	DRAWN BY	CP	DART AEROSPACE LTD HAY KESBURY, ONTARIO, CANADA	
CHECKED	#	APPROVED	#	DRAWING NO. D2617	REV. 0 SHEET 1 OF 1
DATE	01.07.04			TITLE BUSHING	SCALE 1:1
DZ	04.09.10	#	CP	ADD D2617-7	
A	96.10.08			NEW ISSUE	
B	97.05.08			.875 WAS 1.125	
C	97.06.04			0.369 DIA WAS 0.375	
D	01.07.04			ADD MAT'L SPEC AND TOL./DIM. NOTE	
D1	CP	04.07.12	#	CORRECT TOLERANCE (NCR 779)	


D2617-1 (0.375 OD x 0.058 WALL)

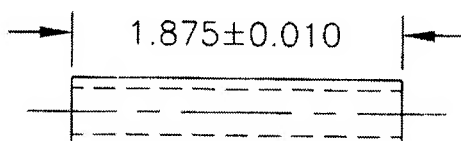

D2617-3 (0.375 OD x 0.058 WALL)

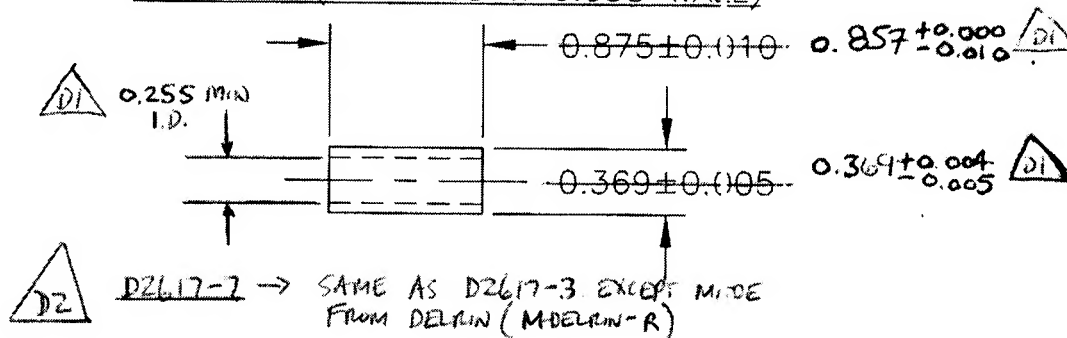

D2617-5 (0.500 OD x 0.058 WALL)

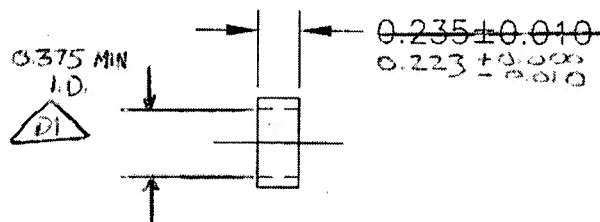

RELEASED
01.07.05

NOTES:

- 1) MATERIAL: 5052-H32 (QQ-A-225/7 OR WW-T-700/4)
OR 6061-T6 (QQ-A-225/8, QQ-A-200/8, OR WW-T-700/6)
- 2) BREAK ALL SHARP EDGES 0.005 TO 0.010
- 3) FINISH: ACID ETCH, ALODINE PER QSI 005 4.1
- 4) TOLERANCES ARE PER DART QSI 018 UNLESS OTHERWISE NOTED
- 5) ALL DIMENSIONS ARE IN INCHES

Copyright © 1996 by DART AEROSPACE LTD

THIS DOCUMENT IS PRIVATE AND CONFIDENTIAL AND IS SUPPLIED ON THE EXPRESS CONDITION THAT IT IS NOT TO BE USED FOR ANY PURPOSE OR COPIED OR COMMUNICATED TO ANY OTHER PERSON WITHOUT WRITTEN PERMISSION FROM DART AEROSPACE LTD.

